

**TENNESSEE DEPARTMENT OF HEALTH AND ENVIRONMENT
 CERTIFICATE OF COMPLETION OF SUBSURFACE SEWAGE DISPOSAL SYSTEM**

Issued to: Burger, Kevin & Valarie
Owner, Developer, Contractor, Installer, Etc.


Location: 1st rd to rt off Kelly rd (Kelly Circle) Doublewide behind first house on st.

Type of System: 1. Standard () 5. Mound
 () 2. Alternating () 6. Lagoons
 () 3. Chapter () 7. Large Diameter Gravelless Pipe
 () 4. Low Pressure Pipe () 8. Other

Baffled Concrete 1000 gal Septic Tank
(type) (volume)

Estimated Absorption Rate 60 to 75
(minutes per inch)

New Installation () Repair
 Installed by: Ray Norton

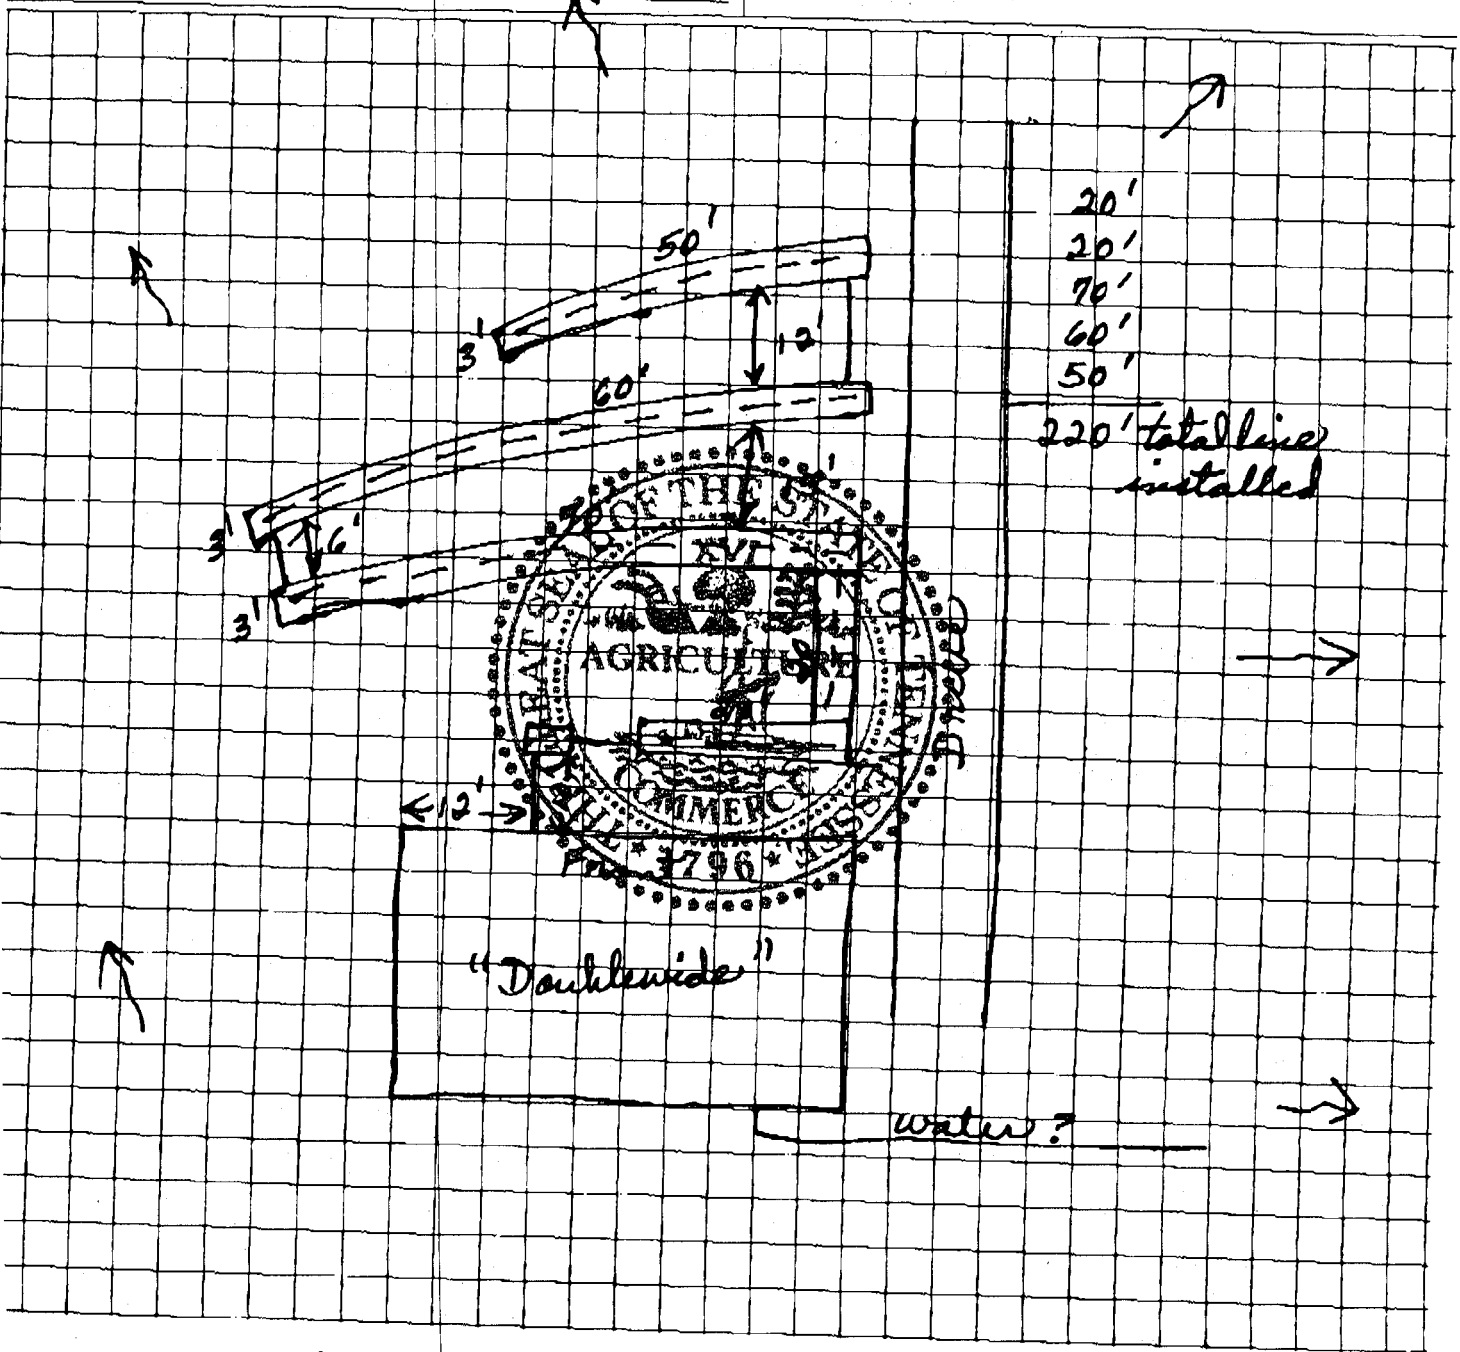

Inspection Approved By: Joe Chandler, Envs Spec. II 09-17-91
(Name and Title) (date)