


UNIT DETAIL

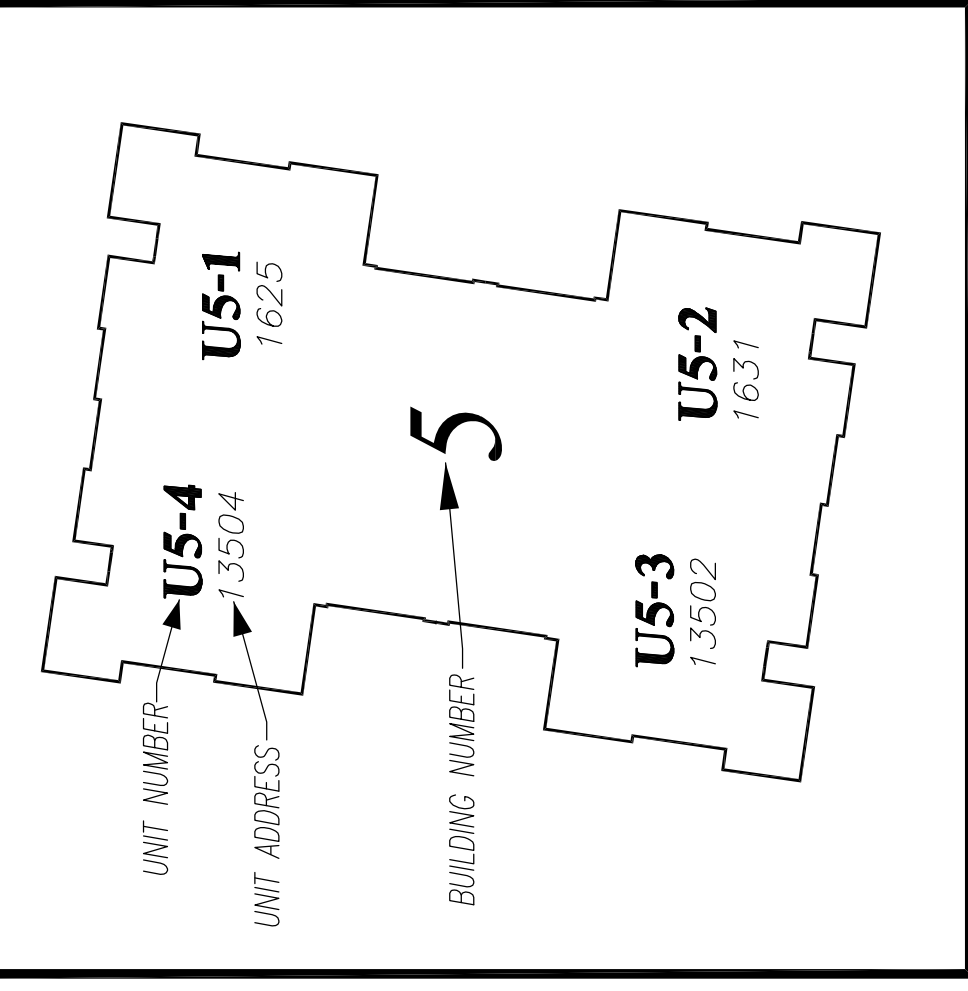

NOTES:


1. Sanitary manhole as-built inverts are ± .05 feet.
2. Sanitary as-built lengths are from center to center of manhole, and are rounded to the nearest foot.
3. All Sanitary as-built locations are approximate.
4. Pipe as-built slopes rounded to the nearest tenth percent.

WATER NOTES


- DESIGN WATER
- DESIGNATES ASBUILT WATER STRUCTURE LOCATION
- DESIGNATES APP-ASSUMED END OF WATER TAP PVC RISER

SANITARY NOTES

- DESIGN SANITARY
- DESIGNATES APP-ASSUMED END OF SANITARY TAP PVC RISER
- DESIGNATES SANITARY ASBUILT INFORMATION

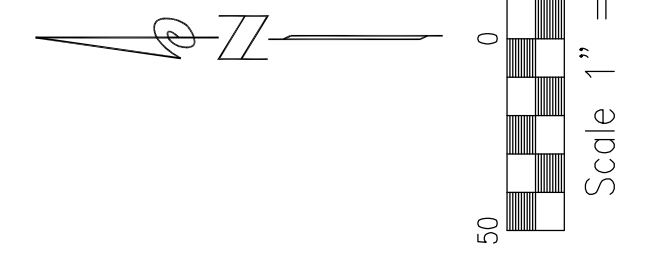

REVISIONS	
DATE	DESCRIPTION

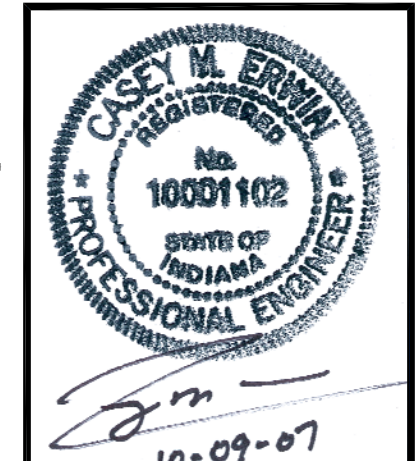

VILLAS AT SUMMIT RESERVE
PHASE ONE
ALLEN COUNTY INDIANA

DABEC
D.A. Brown Engineering Consultants
549 COUNTY ROAD 427 SUITE C. ALBURN IN 46706
PHONE: (260) 925-2020 FAX: (260) 925-1212

UTILITY PLAN
WATER & SANITARY AS-BUILTS