

uc 15148
123837

23 PERMIT FOR CONSTRUCTION OF SUBSURFACE SEWAGE DISPOSAL SYSTEM

Issued to: HENSAR, Malcolm
Owner, Developer, Contractor, Installer, Etc.

To be constructed by ROSSIE EVERETT
(Installer)

Construction of a subsurface sewage disposal system is hereby authorized at:
Acin Oaks Sid Lot 3
(No. and street; Subdivision name and lot no.)

Such a system shall consist of a septic tank of 1000 gals.
with 250 linear feet in 4 trenches,
36 inches wide, and 36 deep
or _____


REGION <u>02</u>	COUNTY <u>05</u>	ID-NUMBER	DATE <u>7/7/86</u>
STAFF <u>112</u>	INSTALLATION: <input checked="" type="checkbox"/> 1. New Installation <input type="checkbox"/> 2. Repair to Existing System		
Type of System: <input checked="" type="checkbox"/> 1. Standard <input type="checkbox"/> 3. Chapter 301 <input type="checkbox"/> 5. Other <input type="checkbox"/> 2. Alternating <input type="checkbox"/> 4. Chapter 212			
For: <input checked="" type="checkbox"/> 1. Residential: No. B/R <u>3</u> <input type="checkbox"/> 2. Commercial/Industrial; Gal/Day _____			
Evaluation based Upon: <input checked="" type="checkbox"/> 1. Soil Typing by Soil Scientist <input type="checkbox"/> 2. Soil Percolation Tests <input type="checkbox"/> 3. Other			
Permeability Rate <u>30 min/line</u>			

The recipient of this permit agrees to construct or have constructed the system in accordance with the rules and regulations under the authority of TCA 53-2054. The recipient must notify the local health authority when the system is ready for inspection. If any part of system is covered before being inspected and approved, it shall be uncovered by the recipient of the permit at the direction of the local health authority.

Robert L. Everett
(Signature of Recipient-Owner, Developer, Contractor, Etc.)

Date 07-07-86

Issued at Manassas, Tennessee in the County of Blount
By For Dept of Health and Env., Howard J. Caldwell Date 6-02-86
(Local Health Authority)

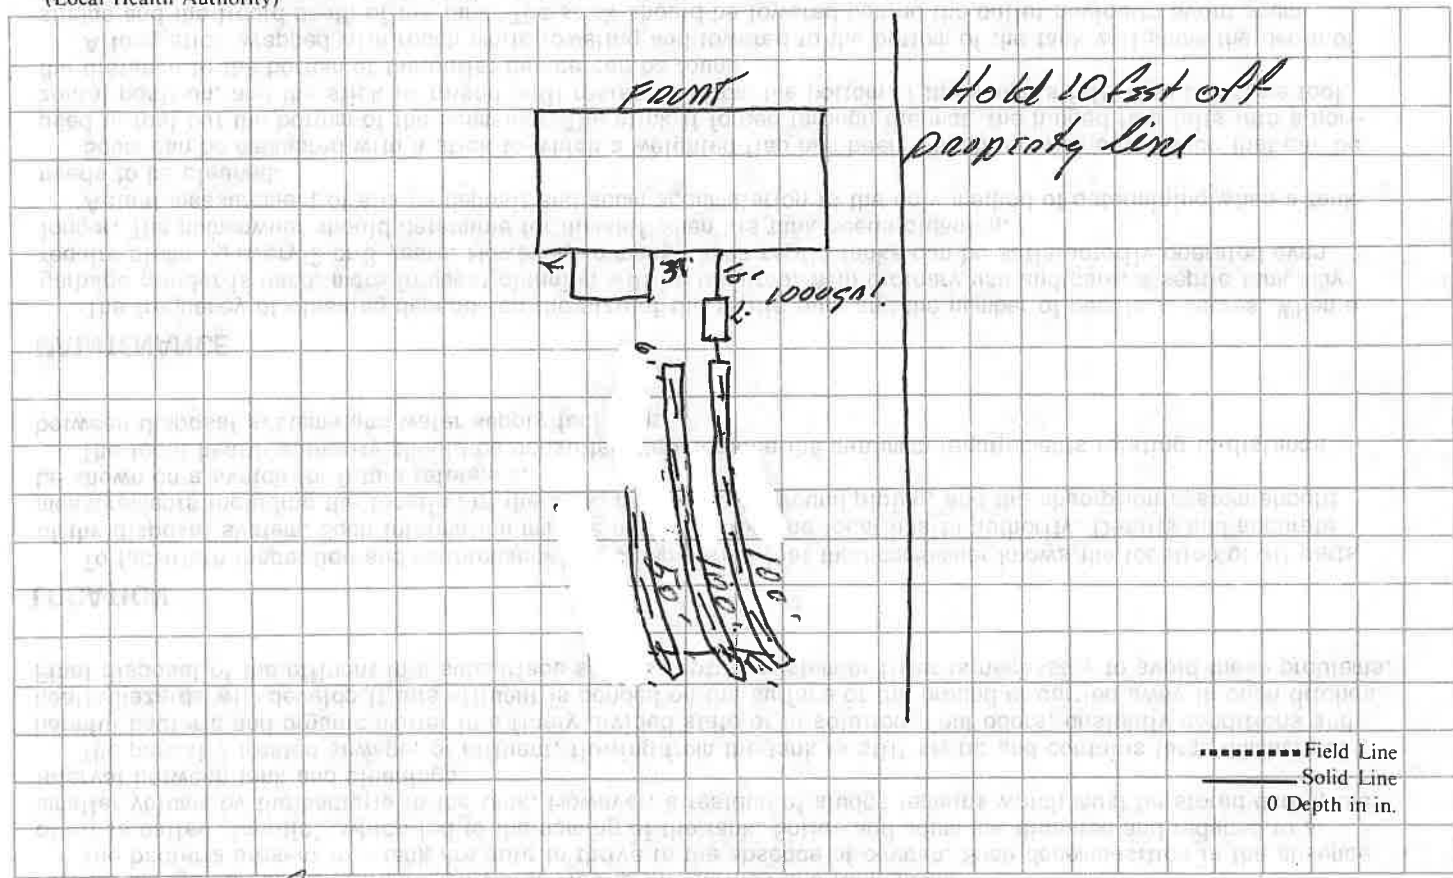

..... Field Line
——— Solid Line
0 Depth in in.

Inspected By Shirley Daniels
Local Health Authority

Construction Approval: 1. Yes 2. No

Date 07-07-86

024

No. of Visits: 2

Time